


Copyright This drawing is the property of Maylands Consulting. Its copyright and design content is reserved by them and the drawing is issued on the condition that it is not copied, reproduced, retained or disclosed to any other unauthorised person, either wholly or in part without the consent in writing of Maylands Consulting. Do not scale this drawing.

Verify all dimensions on site before commencing any work or preparing any shop drawings. All dimensions are in mm unless otherwise stated. Report any alterations or omissions to the Architect. This drawing incorporates information from other professions. Maylands Consulting cannot accept responsibility for the integrity or accuracy of such information. Any clarification and/or additions that are required appertaining to such information should be sought from the relevant party or their appointed representative.

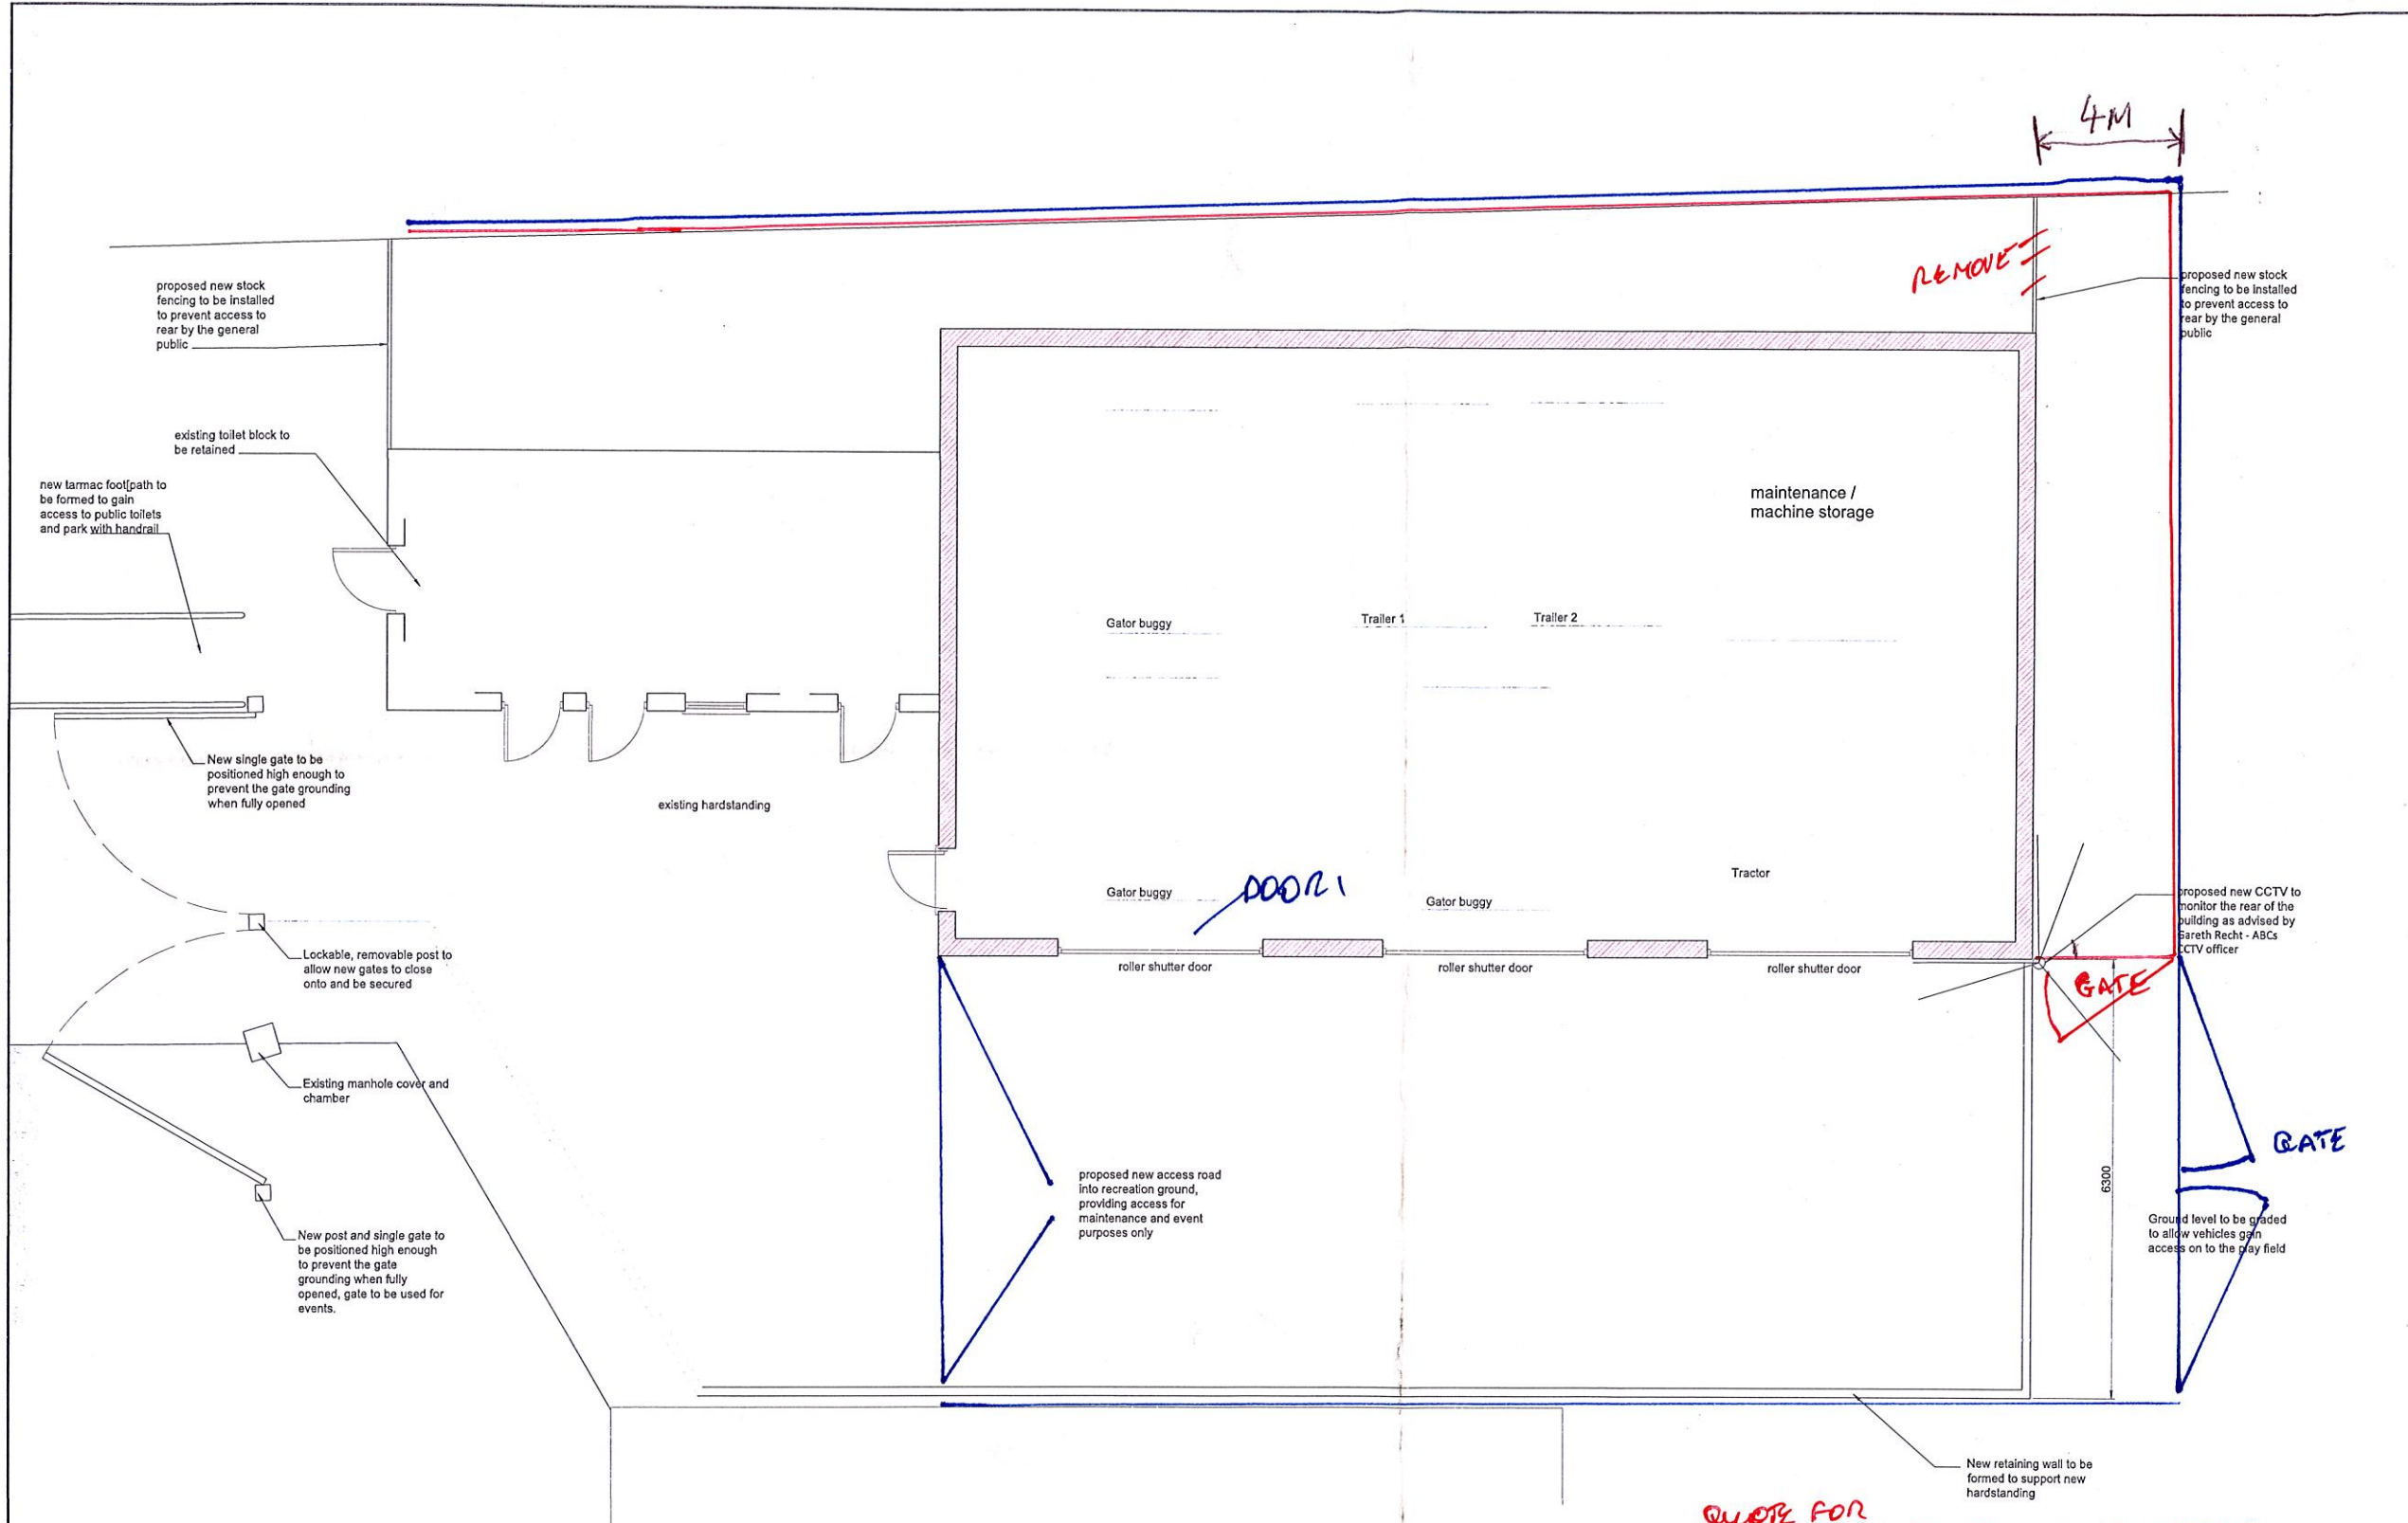

Rev	Details	Name	Date
D	Layout amended notes added following site meeting with TTC	R.F	09-05-18
C	Layout amended following comments from TTC	R.F	03-01-18
B	Layout amended following comments from TTC	R.F	14-11-17
A	Layout amended following comments from ABC	R.F	26-09-17

**RICS** the mark of property professionalism worldwide

**Maylands Consulting**

SURVEYING  
ARCHITECTURAL DESIGN  
PROJECT MANAGEMENT

Milroy House  
Sayers Lane  
Tenterden  
Kent TN30 8BW  
Tel: 01580 761723  
Fax: 01580 761718  
email: mail@maylandsconsulting.co.uk  
www.maylandsconsulting.co.uk  
Regulated by RICS

Client  
Tenterden Town Council  
24 High Street  
Tenterden  
Kent TN30 6AN

Project  
Proposed Extension to Existing Toilet Block to Provide New Maintenance Building  
St Michaels Recreation Ground, Tenterden

Drawing Name  
Proposed Layout Plans

Status  
Planning

Scale  
1:50

Date  
Feb 2017

Drawn By  
R.F

Checked By


Job Number  
MC17007

Drawing No  
003

Revision  
D

**QUOTE FOR OPTION 1 - PLEASE ADD FENCE TO SOUTH ELEVATION £2295 QUOTED FOR WEST ELEVATION**

**OPTION 2 FULL PERIMETER FENCE. NORTH ELEVATION OUTSIDE NEW WALL. L/H ENTRANCE GATE IMPEDES DOOR 1 BUT WOULD ONLY BE USED FOR EVENTS QUOTE PLEASE**

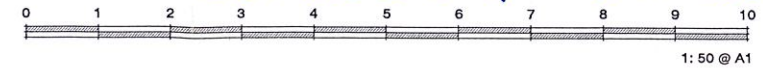

Layout Plan  
scale 1:50 @ A1

Existing Playground